



RED LINE PLAN TO ACCOMPANY ENFORCEMENT NOTICE

Land to the south of Coach House, Stourton Court, Bridgnorth Road, Stourton, Stourbridge, DY7 5BQ

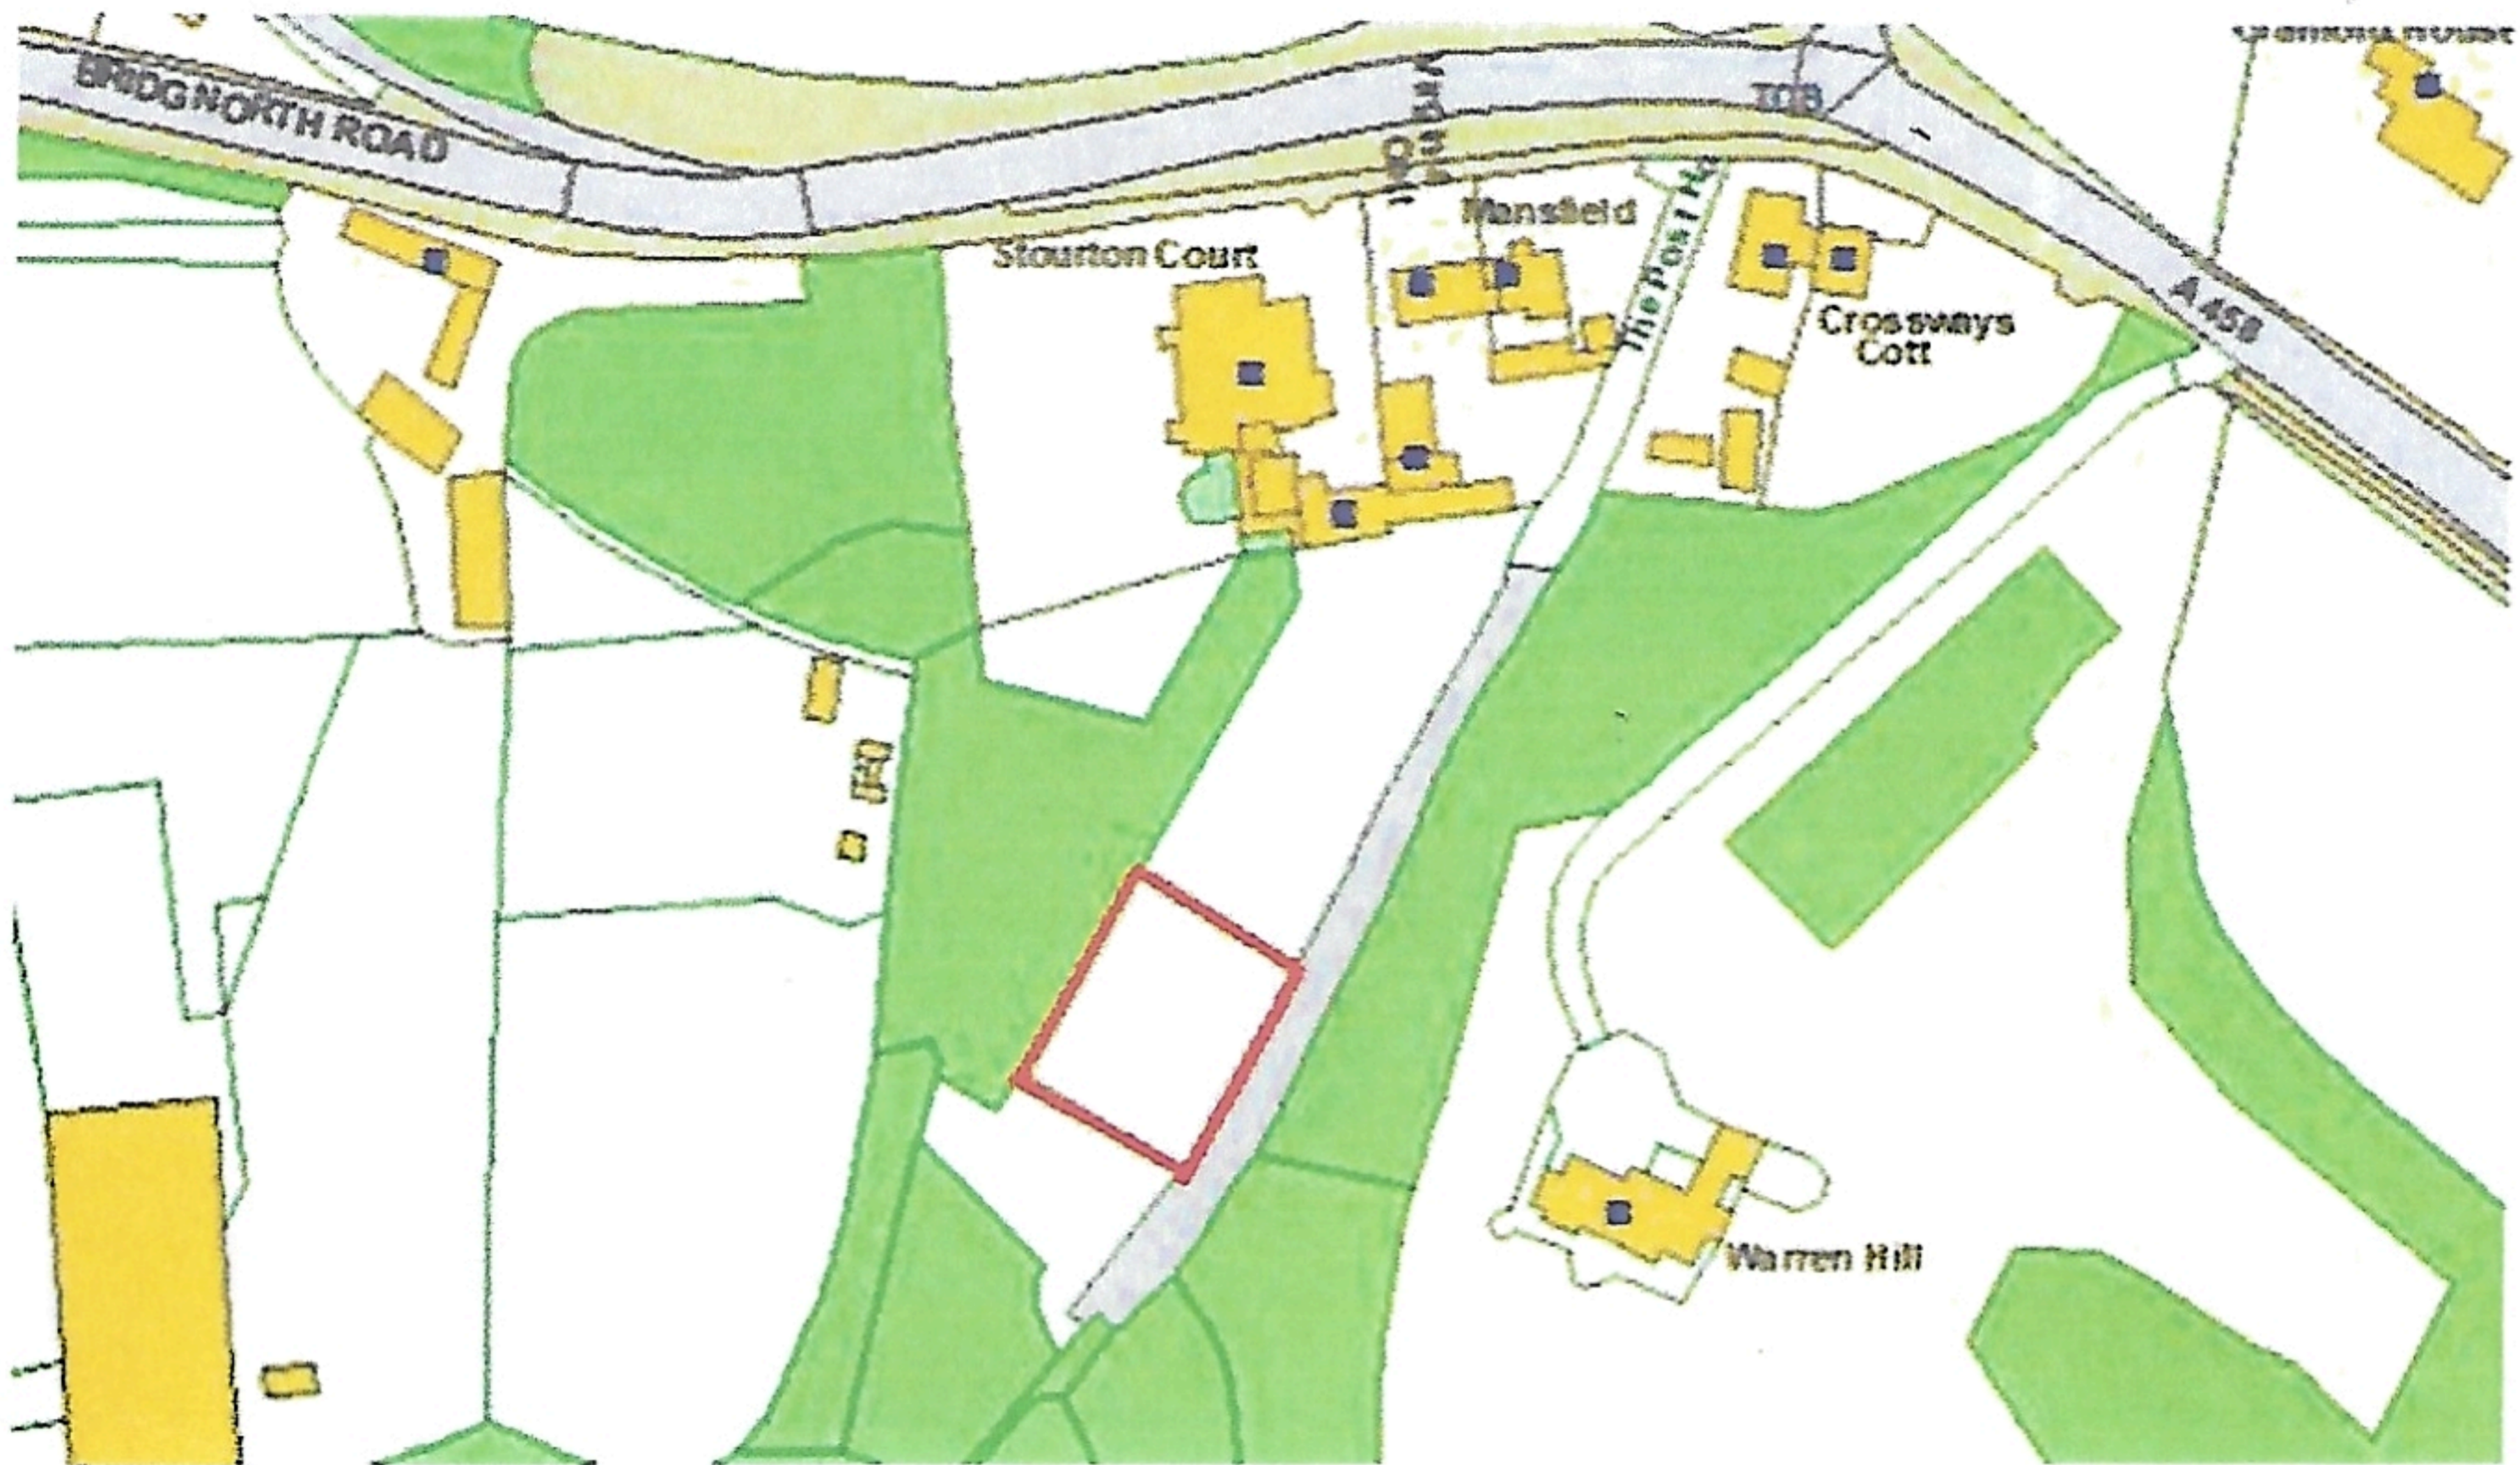

PLANNING ENFORCEMENT REFERENCE: 24/00156/UNCOU

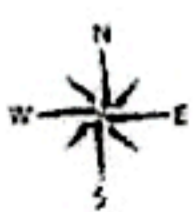

Reproduction from the Ordnance Survey mapping with the permission of the Controller of Her Majesty's Stationary Office © Crown Copyright
Unauthorised reproduction infringes Crown Copyright and may lead to prosecution or civil proceedings
South Staffordshire Council License LA 100019681

SCALE 1:1630

③ your plan showing my property
with no garden's ?